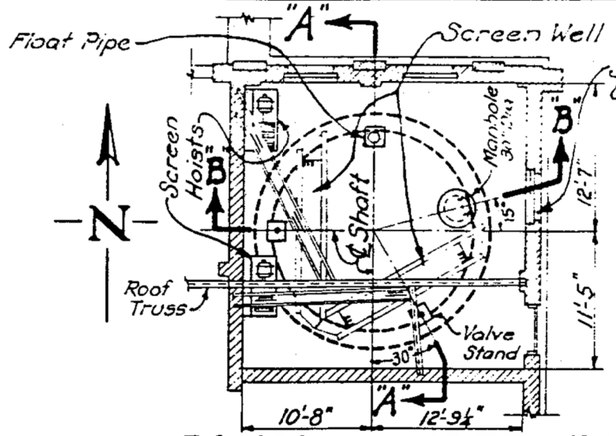

~PLAN OF SCREEN ROOM~

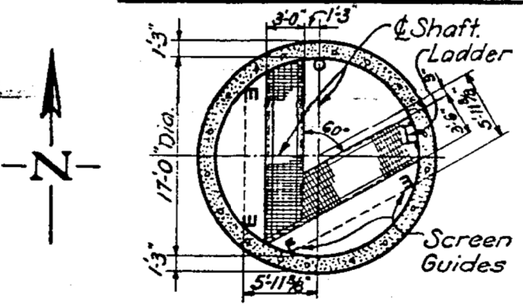

~PLAN OF PLATFORM~ ~AT ELEV.-3.67~

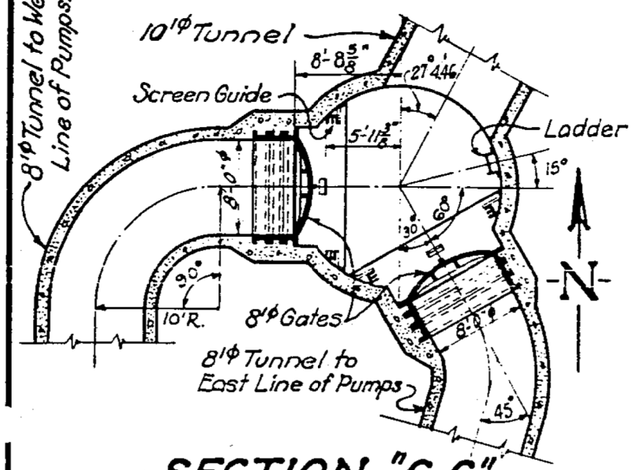

~SECTION~"C-C"~

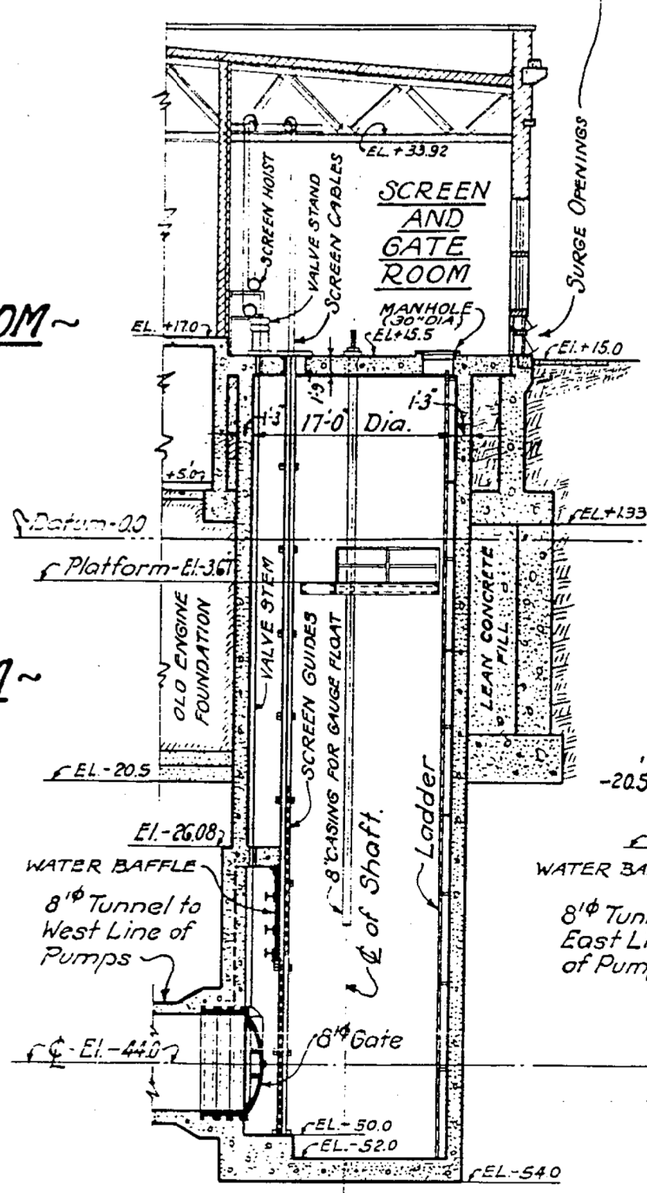

~SECTION~"B-B"~

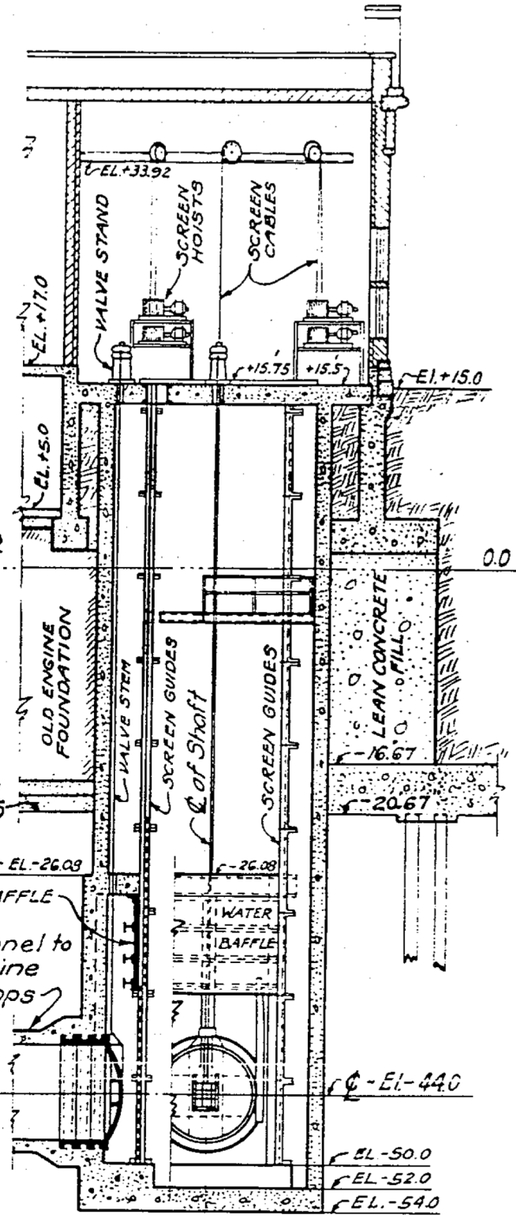

~SECTION~"A-A"~

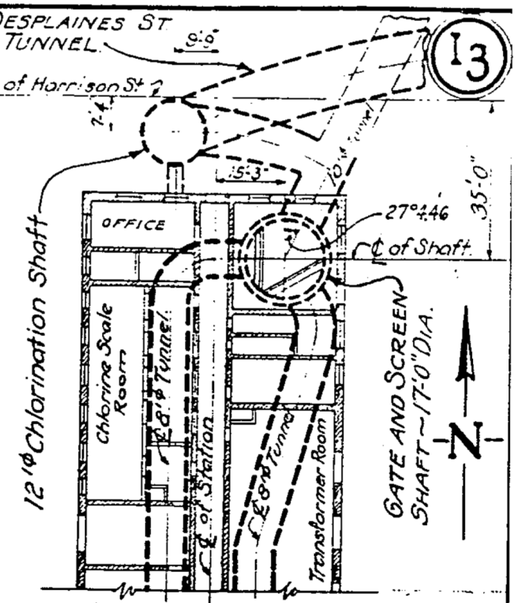

~LOCATION PLAN~

Scale ~ 1"=40'-0"

NOTE:-
For General Plan of Station See Drawing ~ I-2.

FOR INFORMATION ONLY
SUBJECT TO VERIFICATION

CITY OF CHICAGO
DEPARTMENT OF PUBLIC WORKS
BUREAU OF ENGINEERING
DIVISION OF WATER WORKS DESIGN

CERMAK PUMPING STATION
SCREEN AND GATE SHAFT

SCALE: 1 inch = 15 ft.

January 1941

FILE 3-N

FILE NAME = $FILE$

COLLINS ENGINEERS INC

USER NAME = rgall	DESIGNED -	REVISED -
PLOT SCALE = 2.0000 ' / in.	DRAWN -	REVISED -
PLOT DATE = 4/12/2013	CHECKED -	REVISED -
	DATE -	REVISED -

STATE OF ILLINOIS
DEPARTMENT OF TRANSPORTATION

RECORD DRAWING

SCALE: | SHEET NO. OF SHEETS | STA. TO STA.

F.A.I. RTE.	SECTION	COUNTY	TOTAL SHEETS	SHEET NO.
90/94	0101.6-2P-1-3 (13)	COOK	37	15
		CONTRACT NO. 60W36		
FED. ROAD DIST. NO. 1	ILLINOIS	FED. AID PROJECT		