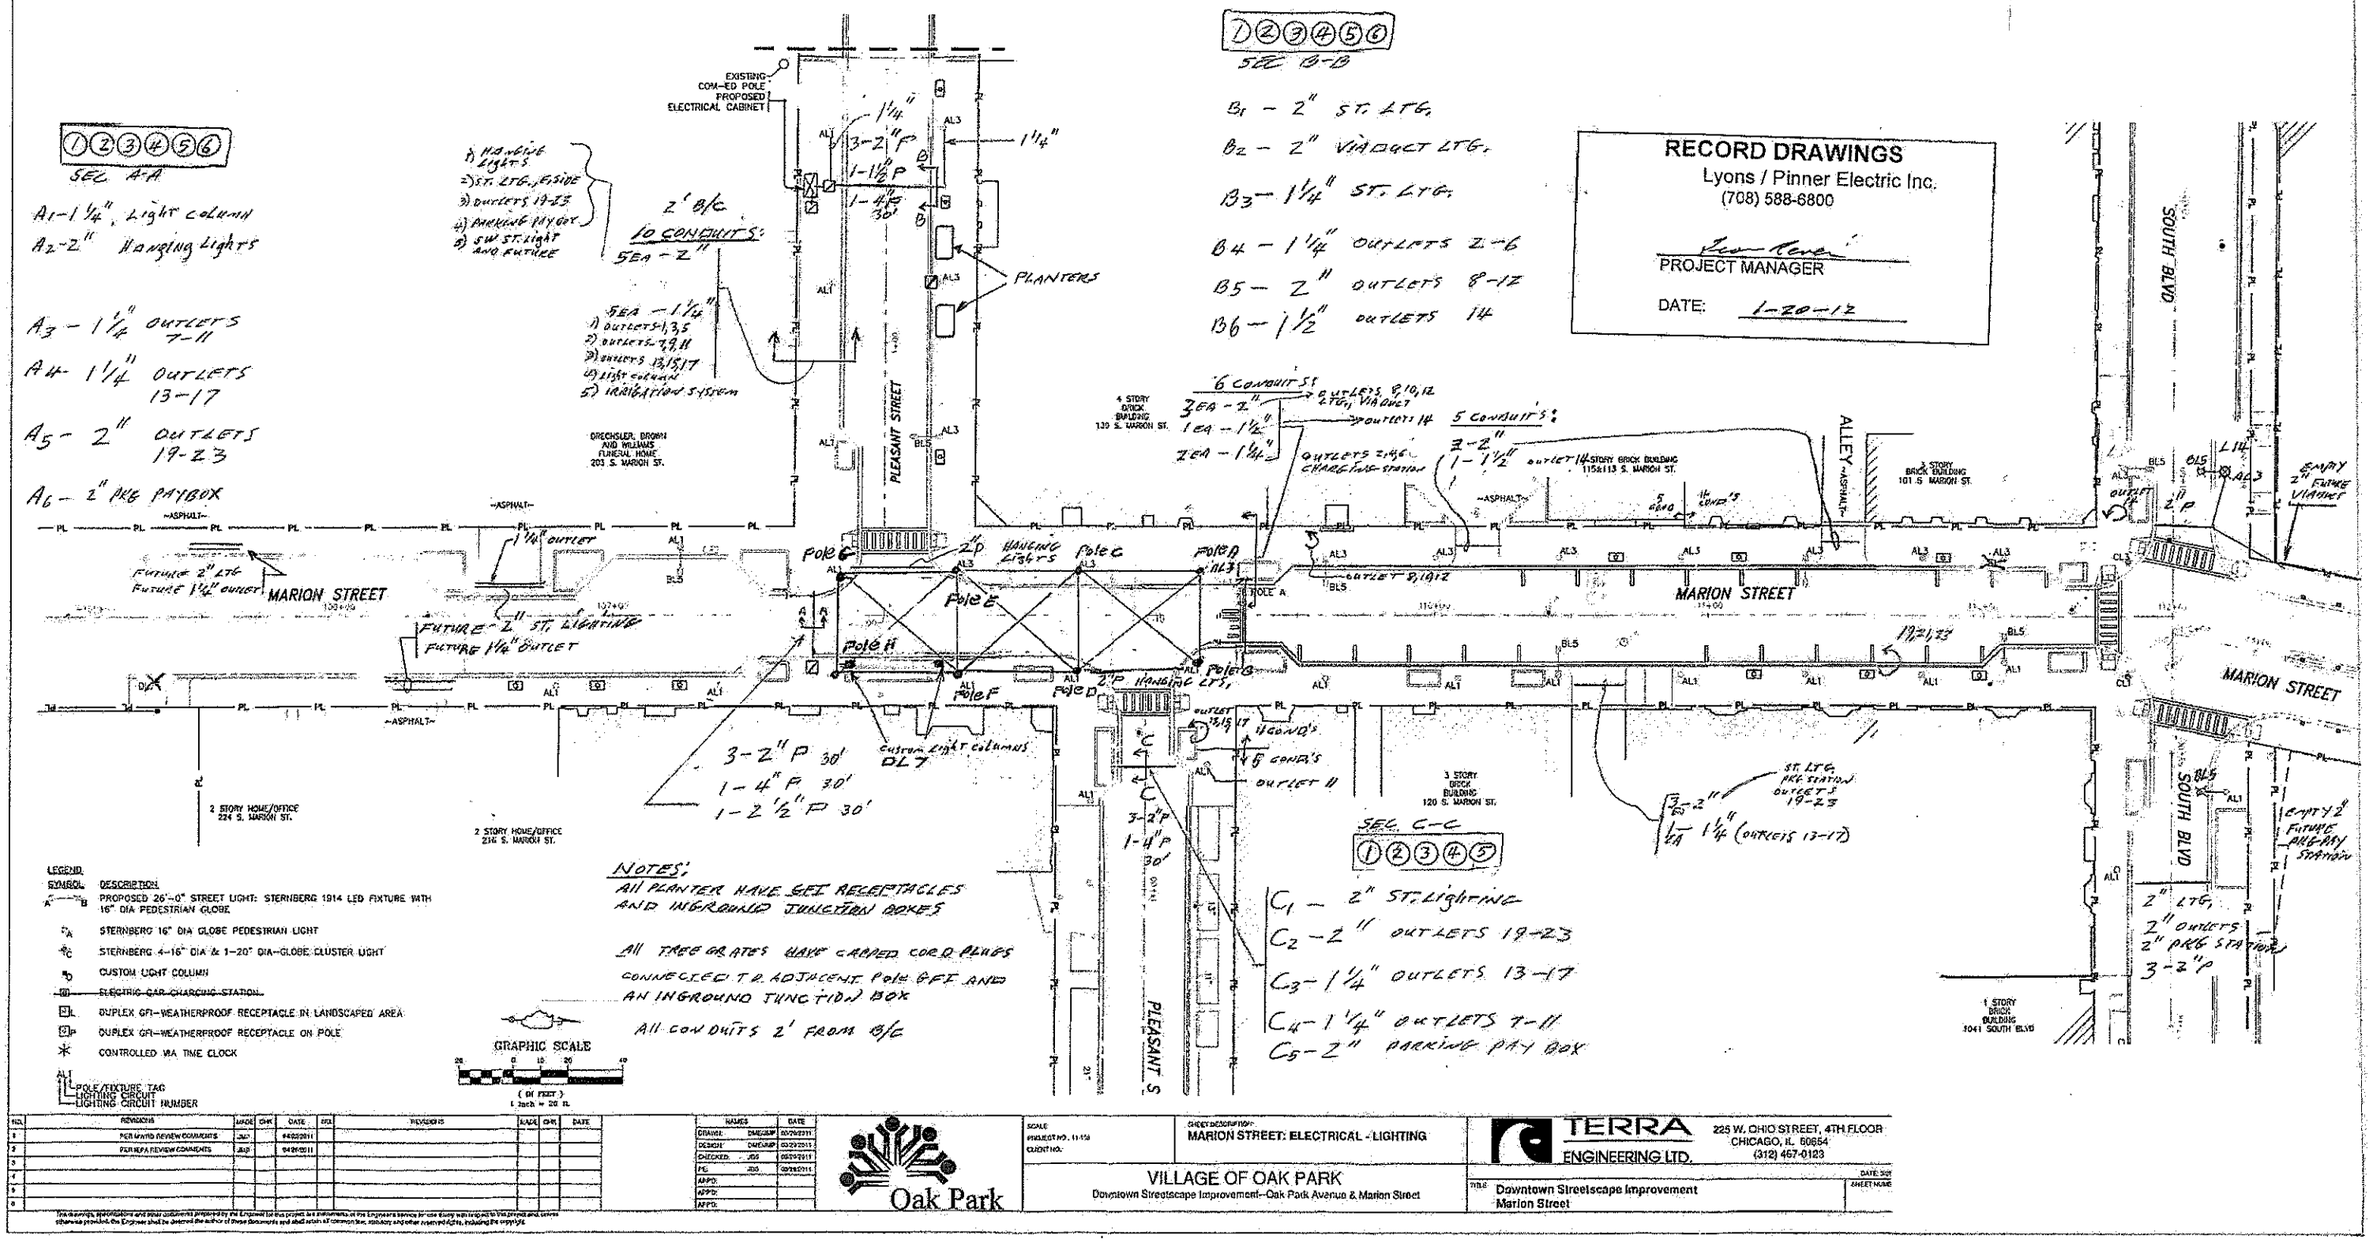

FOR INFORMATION ONLY

FILE NAME = S:\JOL\67881-67949-67784\812\Marion\CADD Sheets\D157722-sht-marion-record.dgn

STRAND ASSOCIATES®
1170 SOUTH HOUBOLT ROAD
JOLIET, ILLINOIS 60431
(815) 744-4200

USER NAME = amandaj	DESIGNED - JDM	REVISED -	
	DRAWN - JKP	REVISED -	
PLOT SCALE = 20.0000 ' / in.	CHECKED - MTC	REVISED -	
PLOT DATE = 5/30/2012	DATE - 05-07-2012	REVISED -	

STATE OF ILLINOIS
DEPARTMENT OF TRANSPORTATION

MARION STREET ELECRICAL PLAN
RECORD DRAWING

SCALE: NTS | SHEET 1 OF 1 SHEETS | STA. | TO STA.

F.A.U. RTE.	SECTION	COUNTY	TOTAL SHEETS	SHEET NO.
2783	11-00253-00-LS	COOK	24	22
		CONTRACT NO. 63722		
		ILLINOIS FED. AID PROJECT		