FOR INFORMATION ONLY

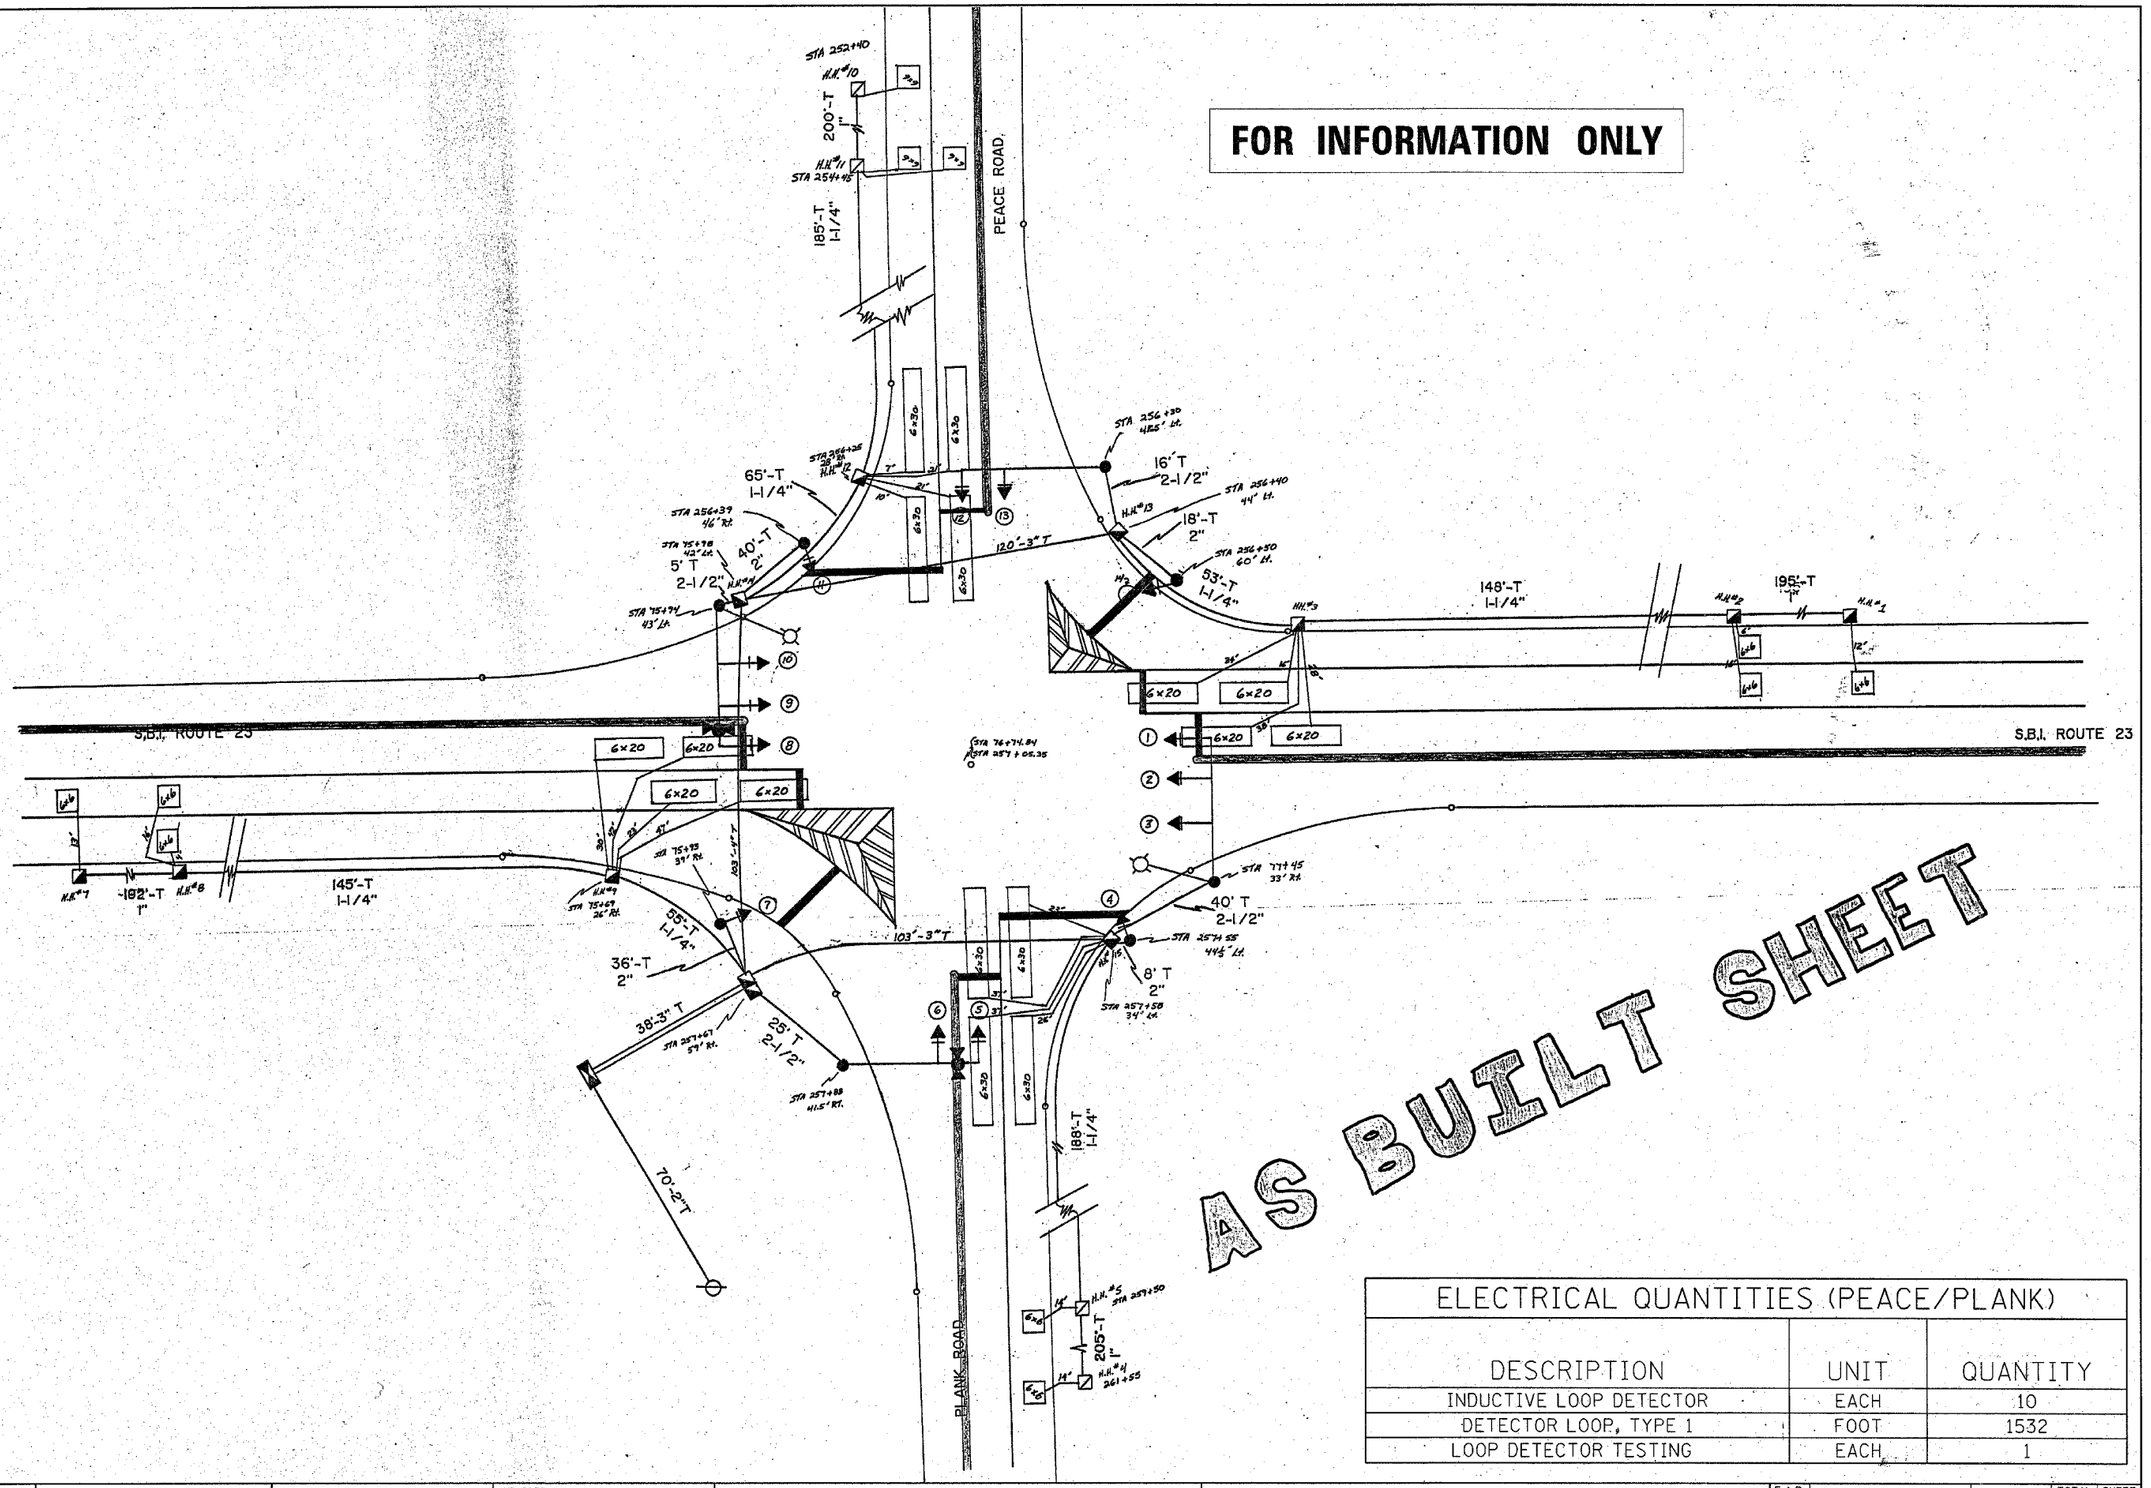

AS BUILT SHEET

ELECTRICAL QUANTITIES (PEACE/PLANK)

DESCRIPTION	UNIT	QUANTITY
INDUCTIVE LOOP DETECTOR	EACH	10
DETECTOR LOOP, TYPE 1	FOOT	1532
LOOP DETECTOR TESTING	EACH	1

FILE NAME = c:\projects\d366676\coversht.dgn	USER NAME = schwankerg	DESIGNED -	REVISED -
		DRAWN -	REVISED -
	PLOT SCALE = 50.0000 ' / IN.	CHECKED -	REVISED -
	PLOT DATE = Apr 16, 2008 - 10:19:24 AM	DATE -	REVISED -

STATE OF ILLINOIS
DEPARTMENT OF TRANSPORTATION

DETECTOR LOOP DETAILS – PLANK/PEACE

SCALE: | SHEET NO. OF SHEETS | STA. | TO STA.

F.A.P. RTE.	SECTION	COUNTY	TOTAL SHEETS	SHEET NO.
324	(25,26)RS-3	DEKALB	24	24
		CONTRACT NO. 66676		
FED. ROAD DIST. NO. 4	ILLINOIS	FED. AID PROJECT		